


PROPOSED LAY-OUT FOR R
S.No. 33 H.No.1. AT VIL-VESHVI.

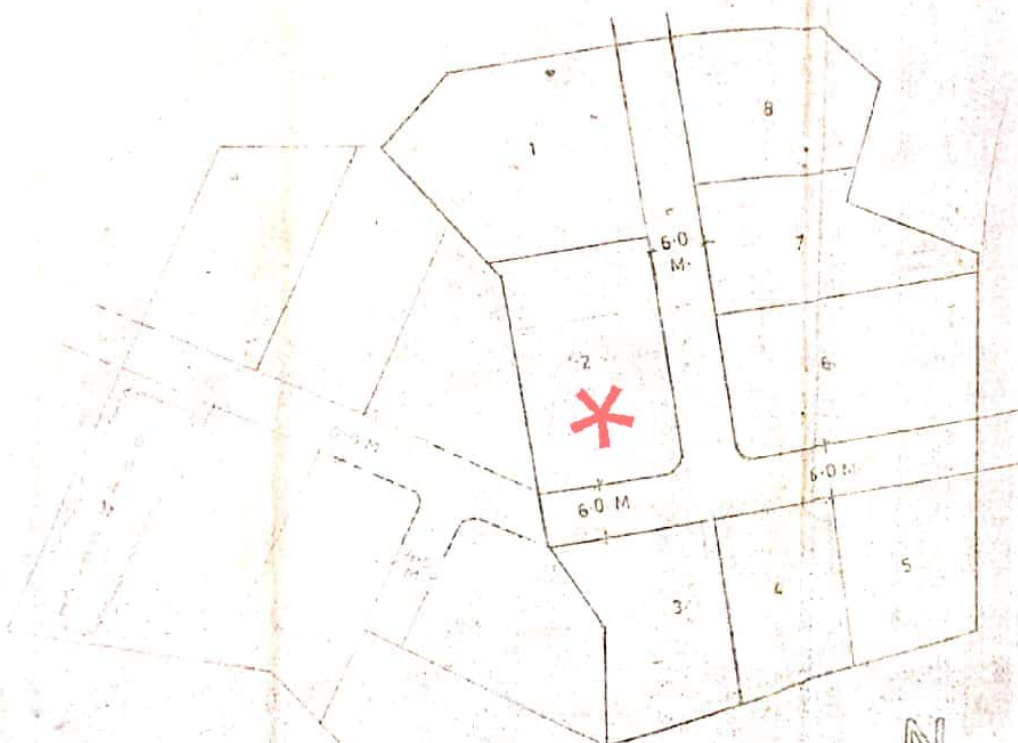

SCALE 1:4000
LOCATION PLAN



म. कोयंबटोरचा जिल्हा मन्त्रालय, वा. वा. ३३३, १९७७
 दिनांक: १०/११/७७ मध्ये मंजूर केलेल्या धर्ती।
 लीटर वेगवेगळ्या लक्षिताने। संपूर्ण मंजूर
 एक संज्ञा करवनात येत आहे।
 (जी. टी. चव्हाण)
 जिल्हाधिकारी




SCALE-1:500


म. कोयंबटोर जिल्हा मन्त्रालय, वा. वा. ३३३, १९७७
 दिनांक: १०/११/७७ मध्ये मंजूर केलेल्या धर्ती।
 लीटर वेगवेगळ्या लक्षिताने। संपूर्ण मंजूर
 एक संज्ञा करवनात येत आहे।

निर्धारित
 मंजूर इत्यादी


वा. वा. ३३३, १९७७ मध्ये मंजूर केलेल्या धर्ती।
 लीटर वेगवेगळ्या लक्षिताने। संपूर्ण मंजूर

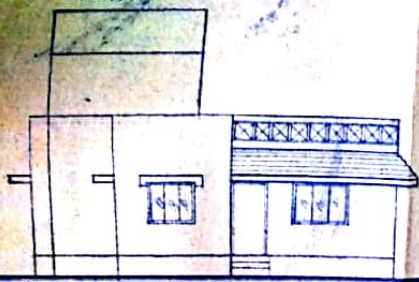

FRONT SIDE ELEVATION
SCALE 1:100

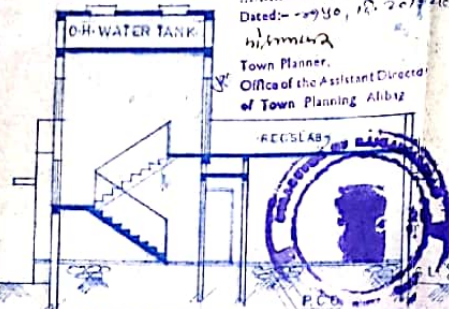


SECTION AT AA
SCALE 1:100

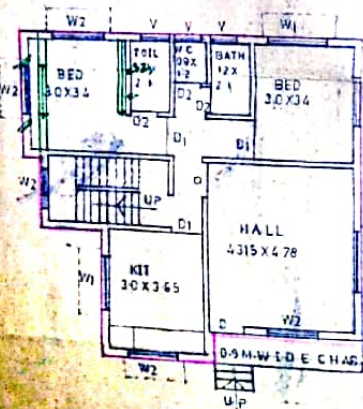


GROUND FLOOR PLAN
SCALE 1:100


DOOR & WINDOW SCHEDULE		
TYPES	SIZE	DESCRIPTION
D	1.00x2.1	T.W. PANELLED
D1	0.90x2.1	T.W. PANELLED
D2	0.76x2.0	T.W. PANELLED
W1	1.7x1.2	T.W. GLAZED
W2	1.5x1.2	T.W. GLAZED
V	0.76x0.7	LOUVERED WINDOW

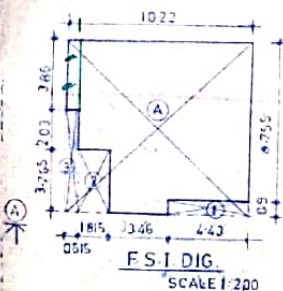

F.S.I. DIG.
SCALE 1:200

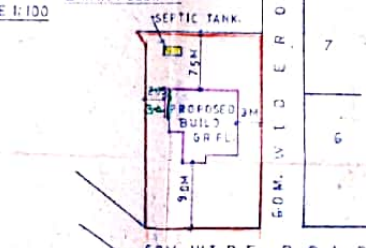

SITE PLAN
SCALE 1:500

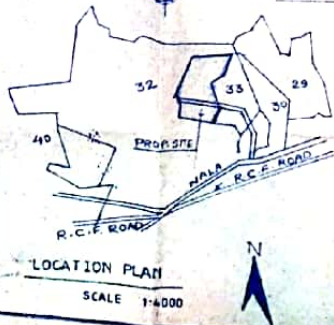

LOCATION PLAN
SCALE 1:4000

Approved as amended in
green for N. A. Permission for
purpose Subject to the
condition mentioned in
the order No. N. A.
No. 211/21997
Collector of Raigad,
ALIBAG.

Town Planner,
Office of the Assistant Director
of Town Planning Alibag

BUILT UP AREA CALCULATION	
BUILT UP AREA CALCULATION ON GR.FL.	
①	10.22 X 9.695 = 98.674 SQM.
②	4.43 X 0.9 = 3.987
③	1.815 X 3.765 = 6.83
④	5.795 X 0.515 = 2.984
TOTAL B.U.P AREA ON GR. FL. = 112.48	
PROPOSED B.U.P AREA ON GR.FL. = 64.87	

AREA STATEMENT	
AREA OF PLOT	= 426.00 M ²
PERMISSIBLE F.S.I.	= 0.2
PERMISSIBLE AREA ON GR.FL.	= 85.2
PROPOSED B.U.P AREA ON GR.FL.	= 64.87
BALANCED AREA	= 0.33

WORK COMPLETED SHOWN IN BLACK
PLOT BOUNDRY SHOWN IN RED
PROPOSED WORK SHOWN IN PINK
DRAINAGE LINE SHOWN IN YELLOW

PROPOSED DUNGLOW ON PLOT BEARING NO. 2
S. NO. 4 HNO. OF VILLAGE SONOHALPADA.
TAL. ALIBAG. DIST. RAIGAD.
FOR:- MR. DILIP APPARAO KHADATARE.

OWNER'S SIGN: *[Signature]*
ARCHITECT'S SIGN: *[Signature]*

JOB. NO. 327
DRG. NO. 1
DATE: 05-09-97
DRN. BY: SURESH
APP. BY: S. MHATRE

VISU SUJATA MHATRE.
B. ARCH. A.IIA
ARCHITECT, INTERIOR DESIGNER
R-39 ARUNA COMPLEX,
SHREEBAUG NO. 3 ALIBAG.
PHONE - 24377